THIS DRAWING IS UNPUBLISHED. RELEASED FOR PUBLICATION -
© COPYRIGHT - - ALL RIGHTS RESERVED.

LOC	DIST
AL	2

REVISIONS

P	LTR	DESCRIPTION	DATE	DWN	APVD
	A3	OBSOLESCENCE OF PN 737735-1, -2, -3	13AUG2014	KJK	JK

	PART NUMBER	SECTION mm2	L1	L2	D1	D2	COLOR	QTY/BAG
	737730-1	0.5	12.0	6.0	1.0	2.6	WHITE	200
	737730-2		14.0	8.0				
	737730-3		16.0	10.0				
	737731-1	0.75	12.0	6.0	1.2	2.8	GREY	200
	737731-2		14.0	8.0				
	737731-3		16.0	10.0				
	737731-4		18.0	12.0				
	737732-1	1.0	12.0	6.0	1.4	3.0	RED	200
	737732-2		14.0	8.0				
	737732-3		16.0	10.0				
	737732-4		18.0	12.0				
	737733-1	1.5	14.0	8.0	1.7	3.5	BLACK	200
	737733-2		16.0	10.0				
	737733-3		18.0	12.0				
OBSOLETE	~~737733-4~~		24.0	18.0				
	737734-1	2.5	14.0	8.0	2.2	4.2	BLUE	100
	737734-2		18.0	12.0				
OBSOLETE	~~737734-3~~		24.0	18.0				
OBSOLETE	~~737735-1~~	4.0	17.0	10.0	2.8	4.8	GREY	100
	~~737735-2~~		20.0	12.0				
	~~737735-3~~		26.0	18.0				
	737736-1	6.0	20.0	12.0	3.5	6.3	YELLOW	100
OBSOLETE	~~737736-2~~		26.0	18.0				
	737737-1	10.0	22.0	12.0	4.5	7.6	RED	50
	737737-2		28.0	18.0				
	737738-1	16.0	24.0	12.0	5.8	8.8	BLUE	50
	737738-2		28.0	18.0				
	737739-1	25.0	30.0	16.0	7.3	11.2	YELLOW	50
	737739-2		30.0	18.0				
	737739-3		36.0	22.0				
	737740-1	35.0	30.0	16.0	8.3	12.7	RED	25
	737740-2		30.0	18.0				
	737740-3		39.0	25.0				
	737741-1	50.0	36.0	20.0	10.3	15.0	BLUE	25
5 OBSOLETE	~~737741-2~~		40.0	25.0				

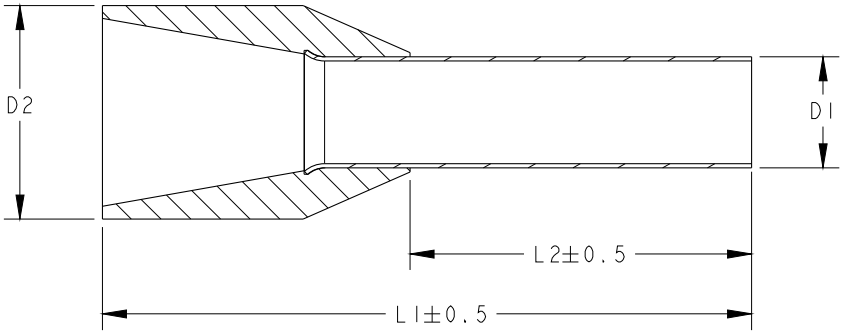

1. DIMENSIONS BASED ON DIN 46228.4
2. COLOR BASED ON DIN 47002
3. USE HAND TOOL 790081-1 FOR 0.5-4.0 mm2.

   USE HAND TOOL 790081-2 FOR 6.0-16.0 mm2

4 FINISH FOR METAL SLEEVE: TIN

5 OBSOLETE PARTS: OBSOLETE CIS STREAMLINING PER D.RENAUD/D.SINISI

1. DIMENSIONES BASADAS EN DIN 46228.4
2. COLOR BASADO EN DIN 47002
3. USAR HERRAMIENTA MANUAL 790081-1 PARA 0.5-4.0mm2.

   USAR HERRAMIENTA MANUAL 790081-2 PARA 6.0-16.0mm2.

4 ACABADO PARA EL CASQUILLO METALICO: ESTAÑADO.

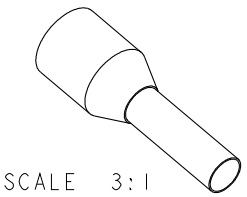

THIS DRAWING IS A CONTROLLED DOCUMENT.

DIMENSIONS: mm

TOLERANCES UNLESS OTHERWISE SPECIFIED:
0 PLC ±-
1 PLC ±0.3
2 PLC ±-
3 PLC ±-
4 PLC ±-
ANGLES ±-

MATERIAL Cu-E PA 6.6

FINISH 4

DWN F.J.CARBONELL 10JUL2001
CHK J.PASCUAL 10JUL2001
APVD - -
PRODUCT SPEC 108-22049
APPLICATION SPEC -
WEIGHT -

TE Connectivity

NAME WIRE PIN

SIZE	CAGE CODE	DRAWING NO	RESTRICTED TO
A3	00779	C-737730	-

Customer Drawing | SCALE NTS | SHEET 1 OF 1 | REV A3